
Exhibit B - Preliminary Site Plan with Outdoor Storage

Add/adjust fence to follow red line as solid fence (not chain link, even if with slats or mesh)

Incorporate landscape buffering on outside of fence

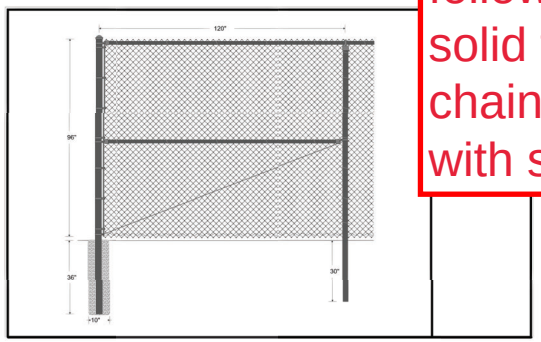

8' TALL BLACK VINYL COATED CHAIN LINK FENCE SPECIFICATIONS

Outdoor storage permitted in purple shaded area only

1 ARCHITECTURAL SITE PLAN
1" = 40'-0"

BRIOHN DESIGN GROUP

ARCHITECTURAL SITE PLAN

PROPOSED BUILDING FOR:
THE DICKMAN CO.
YAHARA RD
DEFOREST, WI

JOB:	223462
DRAWN:	NS
CHECKED:	DF
DATE:	2024-03-26
SHEET:	A0.3